

LABOR AND MATERIALS

1	Copper Lead	} Connection _____ \$	
1	Curb		} Cock Valve T.S. & V. } _____ in. \$
1	Service box Old returned	{ Short 3 1/2 x 4 1/2 Long 4 1/2 x 5 1/2 Buff. or Rdway }	
10	Ft. _____ in.		{ Copper C.I. } Pipe at 3/4
	Nipples _____ in. at _____		\$
	Bushings _____ to _____ in. at _____		\$
	Red'g } Inc'g } Coupl'gs _____ to _____ in. at _____		\$
	Union _____ in. at _____		\$
	Meter _____ in. at _____		\$
	Lead Joints at _____		\$
	Compound Joints at _____		\$
	Maintenance Foreman _____		\$
	Hrs. Water Maint. Man—1 at _____		\$
	Hrs. Water Maint. Man—2 at _____		\$
	Hrs. Garage Foreman _____ at _____		\$
	Hrs. Labor— _____ at _____		\$
	Hrs. Compressor at _____		\$
	Compensation Ins. at \$ _____ per C _____		\$
	Trucking _____		\$
	Pav't Patch _____		\$
	_____		\$
	_____		\$
	_____		\$
	O'head _____		\$
	_____		\$


St.
Pl.
Ave. No. 13

Ash Ave

Name of Owner

Labor and Mat'l. Report

19

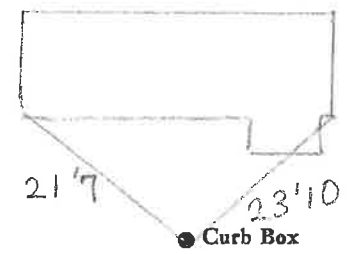

2" Main

Elev. of
Main at tap 4 1/2

Gate at ●

● Gate at

● Curb Box

New Copper

4/30/77