


LABOR AND MATERIALS

1	Copper Lead	Connection	1/2	\$	2.70
1	Curb	Cock Valve T.S. & V.	in. 3/4	\$	2.39
1	Service box Old returned	Short 3 1/2 x 4 1/2 Long 4 1/2 x 5 1/2 Buff or Rdway		\$	1.45
32	Ft.	Copper G.I. Pipe at	3/4	\$	8.64
	Nipples	in. at		\$	
1	Bushings	1/2 to 3/4 in. at		\$.10
	Red'g Inc'g	Coupl'gs to in. at		\$	
	Union	in. at		\$	
	Meter	in. at		\$	
	Lead Joints	at		\$	
	Compound Joints	at		\$	
	Maintenance Foreman			\$	
	Hrs. Water Maint. Man-1	at		\$	
	Hrs. Water Maint. Man-2	at		\$	
	Hrs. Garage Foreman	at		\$	
	Hrs. Labor	at		\$	
	Hrs. Compressor	at		\$	
	Compensation Ins.	at \$ per C		\$	
	Trucking			\$	
	Pav't Patch			\$	
	O'head			\$	

Ash Ave St. Pl. Ave. No. 16

Name of Owner _____

Labor and Mat'l. Report 19

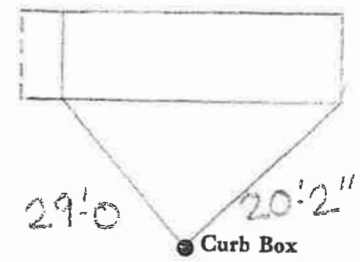

2" Main Elev. of Main at tap 5 1/2

Gate at ● ● Gate at

● Curb Box