


LABOR AND MATERIALS

1	Copper Lead	} Connection $\frac{3}{4}$	\$
1	Curb		} Cock Valve } $\frac{3}{4}$ in. } T.S. & V.
1	Service box	} Short $3\frac{1}{2} \times 4\frac{1}{2}$ } Long $4\frac{1}{2} \times 5\frac{1}{2}$ } Old returned } Buff or Rdway }	
13	Ft. $\frac{3}{4}$ in.		} Copper } G.I. } G.I. }
	Nipples	in. at \$	
	Bushings	to in. at \$	
	Red'g } Inc'g }	} Coupl'gs to in. at \$	
	Union		in. at \$
	Meter	in. at \$	
	Lead Joints	at \$	
	Compound Joints	at \$	
	Maintenance Foreman	\$	
	Hrs. Water Maint. Man-1	at \$	
	Hrs. Water Maint. Man-2	at \$	
	Hrs. Garage Foreman	at \$	
	Hrs. Labor	at \$	
	Hrs. Compressor	at \$	
	Compensation Ins. at \$	per C \$	
	Trucking	\$	
	Pav't Patch	\$	
	O'head	\$	
	TAP BY MOGUIN	\$	

St. Pl. Ave. No. 19  
Ashley Pl.  
 Name of Owner

Labor and Mat'l. Report 12-22 1950

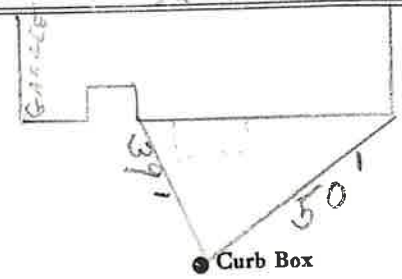

12" Main Elev. of Main at tap 5'  
 Gate at • Gate at •

• Curb Box