


LABOR AND MATERIALS

1	Copper	} Connection	<u>3/4</u> "		\$	
	Lead				_____	
1	Curb	Cock Valve	} <u>3/4</u> in.		\$	
		T. S. & V.			_____	
1	Service box	}	Short $3\frac{1}{2} \times 4\frac{1}{2}$		\$	
	Old returned		Long $4\frac{1}{2} \times 5\frac{1}{2}$		_____	
			Buff or Rdway		_____	
32	Ft.	Copper	}	Pipe at	\$	
	<u>3/4</u> in.	C.I.			_____	
		C.I.			_____	
	Nipples	in. at			\$	
	Bushings	to in. at			\$	
	Red'g	}	Coupl'gs	to in. at	\$	
	Inc'g				_____	
	Union	in. at			\$	
	Meter	in. at			\$	
	Lead Joints at				\$	
	Compound Joints at				\$	
	Maintenance Foreman				\$	
	Hrs. Water Maint. Man—1 at				\$	
	Hrs. Water Maint. Man—2 at				\$	
	Hrs. Garage Foreman	at			\$	
	Hrs. Labor—	at			\$	
	Hrs. Compressor at				\$	
	Compensation Ins. at \$	per C			\$	
	Trucking				\$	
	Pav't Patch				\$	
					\$	
					\$	
	O'head				\$	
					\$	

St. _____
Pl. _____
Ave. No. 20

Name of Owner _____

Labor and Mat'l. Report MAY 28 1952

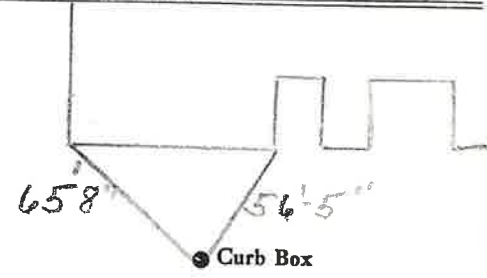

12" Main Elev. of Main at tap 4'

Gate at ● ● Gate at

● Curb Box