

LABOR AND MATERIALS


1	Copper Lead	Connection	3/4	\$	
1	Curb	Cock Valve T.S. & V.	3/4 in.	\$	
1	Service box Old returned	{ Short 3 1/2 x 4 1/2 Long 4 1/2 x 5 1/2 Buff. or Rdway }		\$	
10	Ft.	{ Copper G.I. C.I. }	3/4 in. Pipe at	\$	
	Nipples	in. at		\$	
	Bushings	to in. at		\$	
	Red'g Inc'g	Coupl'gs to in. at		\$	
	Union	in. at		\$	
	Meter	in. at		\$	
	Lead Joints	at		\$	
	Compound Joints	at		\$	
	Maintenance Foreman			\$	
	Hrs. Water Maint. Man-1	at		\$	
	Hrs. Water Maint. Man-2	at		\$	
	Hrs. Garage Foreman	at		\$	
	Hrs. Labor	at		\$	
	Hrs. Compressor	at		\$	
	Compensation Ins.	at \$ per C		\$	
	Trucking			\$	
	Pav't Patch			\$	
				\$	
				\$	
				\$	
	O'head			\$	
				\$	

TAP MADE  
ON PERSHING ROAD  
JUNE 12-1951

St. Pl. Ave. No. 21  
ASBURY

Name of Owner

Labor and Mat'l. Report JUNE 12 1951

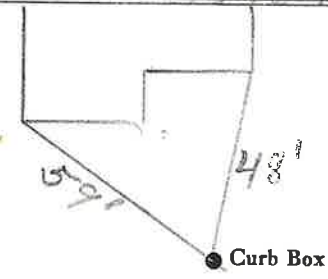

6" Main Elev. of Main at tap 5'

Gate at • Gate at

• Curb Box  
TAP ON PERSHING ROAD