


LABOR AND MATERIALS

1	Copper } Connection $\frac{3}{4}$	\$
	Lead } $\frac{3}{4}$ in.	\$
1	Curb } Cock Valve } T.S. & V. }	\$
		\$
1	Service box } Short $3\frac{1}{2} \times 4\frac{1}{2}$	\$
	Old returned } Long $4\frac{1}{2} \times 5\frac{1}{2}$	
		Buff or Rdway }
25	Ft. $\frac{3}{4}$ in. } Copper } Pipe at	\$
		G.I. }
		G.I. }
	Nipples in. at	\$
	Bushings to in. at	\$
	Red'g } Coupl'gs to in. at	\$
	Inc'g }	\$
	Union in. at	\$
	Meter in. at	\$
	Lead Joints at	\$
	Compound Joints at	\$
	Maintenance Foreman	\$
	Hrs. Water Maint. Man-1 at	\$
	Hrs. Water Maint. Man-2 at	\$
	Hrs. Garage Foreman at	\$
	Hrs. Labor at	\$
	Hrs. Compressor at	\$
	Compensation Ins. at \$ per C	\$
	Trucking	\$
	Pav't Patch	\$
		\$
		\$
		\$
	O'head	\$
		\$

St. PI. Ave. No. 24  
 ASHLEY  
 Name of Owner

Labor and Mat'l. Report 12-19 1950

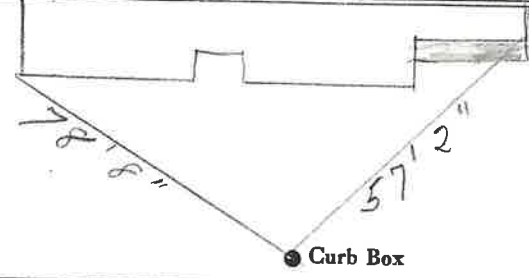

12" Main Elev. of Main at tap 5'  
 Gate at • Gate at •

• Curb Box