

LABOR AND MATERIALS

1	Copper	} Connection	$\frac{3}{4}$	\$		
	Lead					
1	Curb	} Cock Valve T. S. & V.	} $\frac{3}{4}$ in.	\$		
1	Service box				} { Short $3\frac{1}{2}$ x $4\frac{1}{2}$ Long $4\frac{1}{2}$ x $5\frac{1}{2}$ Buff. or Rdway.	\$
	Old returned					
29	Ft. $\frac{3}{4}$ in.	} { Copper G.I. C.I.	} Pipe at	\$		
	Nipples				in. at	\$
	Bushings				to in. at	\$
	Red'g } Inc'g }	} Coupl'gs	to in. at	\$		
	Union				in. at	\$
	Meter	in. at	\$			
	Lead Joints	at	\$			
	Compound Joints	at	\$			
	Maintenance Foreman		\$			
	Hrs. Water Maint. Man-1	at	\$			
	Hrs. Water Maint. Man-2	at	\$			
	Hrs. Garage Foreman	at	\$			
	Hrs. Labor	at	\$			
	Hrs. Compressor	at	\$			
	Compensation Ins. at \$	per C	\$			
	Trucking		\$			
	Pav't Patch		\$			
			\$			
			\$			
	O'head		\$			
			\$			

2078 Block 8
BROAD ACRES

St.
Pl.

ASHLEY


Ave. No.

Name of Owner

TAP ON ASHLEY

Labor and Mat'l. Report

19

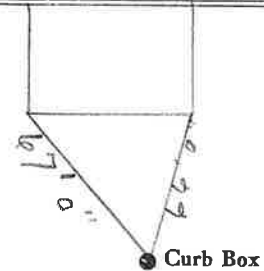

12" Main

Elev. of
Main at tap

4'

Gate at ●

● Gate at

● Curb Box