

LABOR AND MATERIALS

1	Copper	} Connection	3/4"	\$ 2.41	
	Lead				
1	Curb	} Cock	3/4 in.	\$ 3.41	
					} Valve
1	Service box	} Short 3 1/2 x 4 1/2	}	\$ 4.18	
	Old returned				} Long 4 1/2 x 5 1/2
13	Ft. 3/4 in.	} Copper	} Pipe at 40	\$ 5.20	
					} G.I.
	Nipples	in. at		\$	
	Bushings	to	in. at	\$	
	Red'g	} Coupl'gs	to	in. at	\$
	Inc'g				
	Union	in. at		\$	
	Meter	in. at		\$	
	Lead Joints at			\$	
	Compound Joints at			\$	
	Maintenance Foreman			\$	
	Hrs. Water Maint. Man-1 at			\$ 8.16	
	Hrs. Water Maint. Man-2 at			\$	
	Hrs. Garage Foreman	at 1.59		\$ 4.77	
	Hrs. Labor	at 1.13		\$ 3.39	
	Hrs. Compressor at			\$	
	Compensation Ins. at \$3.861 per C			\$ 32	
	Trucking			\$ 1.50	
	Pav't Patch			\$	
	Tap made Oct 21-54			\$	
	by Wadleigh & Larcen			\$	
	O'head			\$	
				\$ 25.18	


25.18

72-54

Ashley St. Pl. Ave. No. 11

Name of Owner D. Kingsley

Labor and Mat'l. Report Oct 31 1954

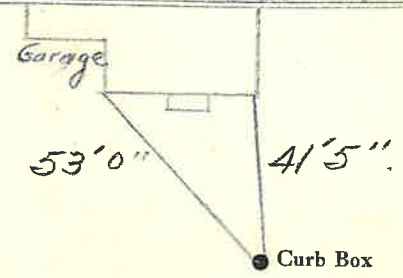

12" Main Elev. of Main at tap 4'

Gate at ● ● Gate at

● Curb Box