

### LABOR AND MATERIALS

/	Copper Lead	} Connection	$\frac{3}{4}$ "		\$
	Curb	} Cock Valve T. S. & V.	$\frac{3}{4}$ in.		\$
/	Service box Old returned	{ Short $3\frac{1}{2} \times 4\frac{1}{2}$ Long $4\frac{1}{2} \times 5\frac{1}{2}$ Buff or Rdway			\$
10	Ft.	$\frac{3}{4}$ in. { Copper C.I. C.I. }	} Pipe at		\$
	Nipples	in. at			\$
	Bushings	to in. at			\$
	Red'g Inc'g	} Coupl'gs to in. at			\$
	Union	in. at			\$
	Meter	in. at			\$
	Lead Joints	at			\$
	Compound Joints	at			\$
	Maintenance Foreman				\$
	Hrs. Water Maint. Man—1	at			\$
	Hrs. Water Maint. Man—2	at			\$
	Hrs. Garage Foreman	at			\$
	Hrs. Labor—	at			\$
	Hrs. Compressor	at			\$
	Compensation Ins. at \$	per C			\$
	Trucking				\$
	Pav't Patch				\$
					\$
					\$
	O'head				\$
					\$


FAP-1951

St. PL. Ave. No. 13

ASHLEY PL.

Name of Owner \_\_\_\_\_

Labor and Mat'l. Report 10 1951

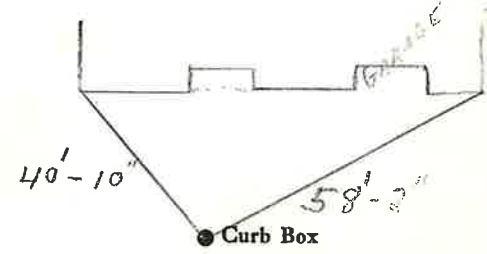

12" Main Elev. of Main at tap  $4\frac{1}{2}$

Gate at ● Gate at ●

● Curb Box