

LABOR AND MATERIALS


1	Copper Lead	} Connection $\frac{3}{4}$	\$	
1	Curb	} Cock Valve T. S. & V. } $\frac{3}{4}$ in.	\$	
1	Service box Old returned	{ Short $3\frac{1}{2} \times 4\frac{1}{2}$ Long $4\frac{1}{2} \times 5\frac{1}{2}$ Buff or Rdway }	\$	
9	Ft. $\frac{3}{4}$ in.	{ Copper G.I. G.I. } Pipe at	\$	
	Nipples	in. at	\$	
	Bushings	to in. at	\$	
	Red'g Inc'g	Coupl'gs to in. at	\$	
	Union	in. at	\$	
	Meter	in. at	\$	
	Lead Joints	at	\$	
	Compound Joints	at	\$	
	Maintenance Foreman		\$	
	Hrs. Water Maint. Man-1	at	\$	
	Hrs. Water Maint. Man-2	at	\$	
	Hrs. Garage Foreman	at	\$	
	Hrs. Labor	at	\$	
	Hrs. Compressor	at	\$	
	Compensation Ins. at \$	per C	\$	
	Trucking		\$	
	Pav't Patch		\$	
			\$	
			\$	
			\$	
	O'head		\$	
			\$	

St.
Pl.
Ave. No. 17

ASHLEY PLACE

Name of Owner

Labor and Mat'l. Report 19

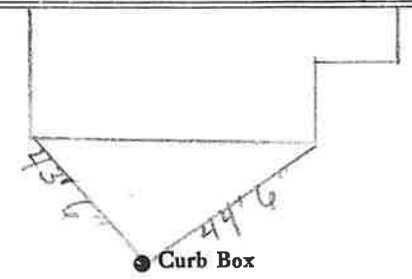

13 Main Elev. of
Main at tap $4\frac{1}{2}$

Gate at ● ● Gate at

● Curb Box