

LABOR AND MATERIALS

1	Copper	} Connection	_____	\$ _____
	Lead			
1	Curb	} Cock Valve T.S. & V.	_____ in.	\$ _____
1	Service box	{ Short 3 1/2 x 4 1/2 Long 4 1/2 x 5 1/2 Buff-or-Rdway	_____	\$ _____
	Old returned			
25	Ft. 3/4 in.	{ Copper C.I. C.I.	_____	\$ _____
	Nipples	in. at _____	\$ _____	
	Bushings	to _____ in. at _____	\$ _____	
	Red'g	} Coupl'gs	_____ to _____ in. at _____	\$ _____
	Inc'g			
	Union	in. at _____	\$ _____	
	Meter	in. at _____	\$ _____	
	Lead Joints	at _____	\$ _____	
	Compound Joints	at _____	\$ _____	
	Maintenance Foreman	_____	\$ _____	
	Hrs. Water Maint. Man-1	at _____	\$ _____	
	Hrs. Water Maint. Man-2	at _____	\$ _____	
	Hrs. Garage Foreman	at _____	\$ _____	
	Hrs. Labor-	at _____	\$ _____	
	Hrs. Compressor	at _____	\$ _____	
	Compensation Ins.	at \$ _____ per C	\$ _____	
	Trucking	_____	\$ _____	
	Pav't Patch	_____	\$ _____	
		_____	\$ _____	
		_____	\$ _____	
		_____	\$ _____	
	O'head	_____	\$ _____	
		_____	\$ _____	


22 AUBURN St. Pl. Ave. No. 22

Name of Owner

CROWN

Labor and Mat'l. Report

DEC 1937

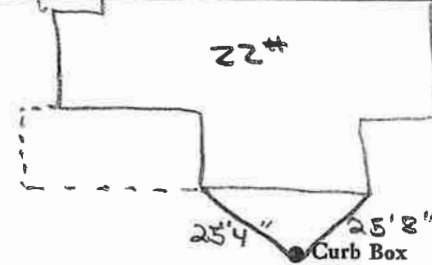

6" Main (C.I.) 1938

Elev. of Main at tap 5

Gate at •

• Gate at

TAX ID # 303.13-16-24

• Curb Box

OLD SHUT OFF