

1 - 3/4" Mueller Brass Plug 35  
**LABOR AND MATERIALS**

1	Copper Lead	Connection	1/2" x 3/4"	\$ 2.63
1	Curb	Cock Valve T.S. & V.	3/4" in.	\$ 3.45
1	Service box	Short	3 1/2 x 4 1/2	\$ 4.70
10	Old returned	Long	4 1/2 x 5 1/2	
8	Ft.	Copper G.I. C.I.	3/4" in. Pipe at 35	\$ 2.80
	Nipples	in. at		\$
	Bushings	to in. at		\$
1	Red'g Inc'g	Coupl'gs	3/4" to 3/4" in. at	\$
	Union	in. at	Cop. To Cop.	\$
	Meter	in. at		\$
	Lead Joints	at		\$
	Compound Joints	at		\$
1	Hrs. Water Maint. Man	-1 at		\$ 1.13
4	Hrs. Labor	at	1.26	\$ 5.04
15	Hrs. Labor	at	1.02	\$ 15.30
	Hrs. Compressor	at		\$ 5.9
	Compensation Ins.	at \$ 2.66 per C.		\$ 1.00
	Trucking			\$ 10.80
	Pav't Patch			\$
	O'head			\$


Tap made by Larcau \$47.11  
 4-13-51

2097

St. Auburn  
 Pl. 9  
 Ave. No. 9

Name of Owner  
Russell

Labor and Mat'l. Report April 13 1951

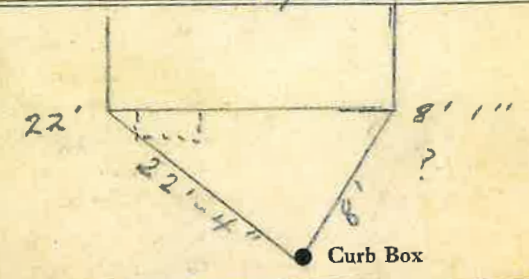

6" C.I. 1958  
 4" G.I. Main Elev. of Main at tap 5'

Gate at ● Gate at ●

TAX ID # 303.13-23-10

● Curb Box