


Labor and Materials

1	Copper	} Connection	3/4	\$ 1.48
1	Lead				
1	Curb	} Cock Valve T.S. or V.	3/4 in	\$ 1.79
1	Service Box				
	Old returned	} Short 3 1/2 x 4 1/2 Long 4 1/2 x 5 1/2 Buff. or Ridg.		\$ 1.30
25	Ft. 3/4 in.				
		} Copper Galv. Iron Cast Iron	} Pipe at	\$ 4.50
	Nipples				
1	Bushings	3/4 to 1/2	in. at	\$ 1.0
	Red'g Inc'g	} Couplings to in. at \$
	Union				
	Meter in. at	\$
	Lbs. Br. Stone	at	\$
	Lbs. Sand	at	\$
	Bags Cement	at	\$
	Paving Brick	} Mack Red Asphalt	} at	\$
	Lead Joints				
	Leadite Joints	at	\$
11	Hrs. Foreman	\$ 6.88
5	Hrs. Common Labor	at	\$ 2.50
	Hrs. Common Labor	at	\$
	Hrs. Mason	at	\$
	Hrs. Masons Helper	at	\$
	Hrs. Compressor	at	\$
	Compensation Ins.	\$ 2.9
	Trucking	\$ 1.00
	Builders Use of Water	Patch	\$ 5.00
Total					\$ 24.84

no 10 Auburn Place

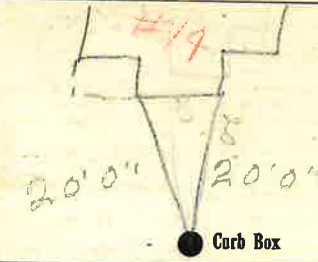

6" C.I. 1958

4" Main Elev. of Main at tap 6'

Gate at ● ● Gate at

● Curb Box
Old tap shut off

[Handwritten signature]

4/17/32