

LABOR AND MATERIALS

1	Copper	Connection	$\frac{3}{4}$ "		\$
	Lead	Cock			
1	Curb	Valve	$\frac{3}{4}$ in.		\$
		T.S. & V.			
1	Service box	}	Short $3\frac{1}{2} \times 4\frac{1}{2}$		
	Old returned		Long $4\frac{1}{2} \times 5\frac{1}{2}$		
			Buff or Rdway		\$
21	Ft.	}	Copper	Pipe at	
	$\frac{3}{4}$ in.		G.I.		
		G.I.			\$
	Nipples	in. at			\$
	Bushings	to in. at			\$
	Red'g	}	Coupl'gs	to in. at	
	Inc'g				
	Union	in. at			\$
	Meter	in. at			\$
	Lead Joints	at			\$
	Compound Joints	at			\$
	Maintenance Foreman				\$
	Hrs. Water Maint. Man	1 at			\$
	Hrs. Water Maint. Man	2 at			\$
	Hrs. Garage Foreman	at			\$
	Hrs. Labor	at			\$
	Hrs. Compressor	at			\$
	Compensation Ins.	at \$	per C		\$
	Trucking				\$
	Pav't Patch				\$
	Tap by Gifford & Co				\$
	7-18-58				\$
	O'head				\$
					\$

V


Huburn

St. Pl. Ave. No. 18

Name of Owner

Michael Gazzillo

Labor and Mat'l. Report July 18 1958

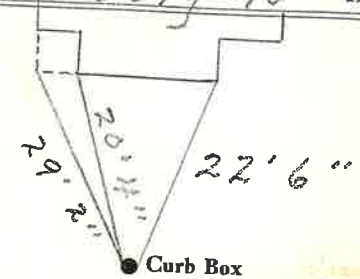

C.I. 1958

6" Main

Elev. of Main at tap 5'

Gate at ●

● Gate at

● Curb Box