

LABOR AND MATERIALS


1	Copper Lead	Connection	3/4	\$
1	Curb	Cock Valve T.S. & V.	3/4 in.	\$
1	Service box	Short 3 1/2 x 4 1/2		
	Old returned	Long 4 1/2 x 5 1/2		
		Bull or Rdway		\$
15	Ft. 3/4 in.	Copper Pipe at		\$
		S.S.		
		C.I.		
	Nipples	in. at		\$
	Bushings	to in. at		\$
	Red'g Inc'g	Coupl'gs to in. at		\$
	Union	in. at		\$
	Meter	in. at		\$
	Lead Joints	at		\$
	Compound Joints	at		\$
	Maintenance Foreman			\$
	Hrs. Water Maint. Man-1	at		\$
	Hrs. Water Maint. Man-2	at		\$
	Hrs. Garage Foreman	at		\$
	Hrs. Labor	at		\$
	Hrs. Compressor	at		\$
	Compensation Ins. at \$	per C		\$
	Trucking			\$
	Pav't Patch			\$
				\$
				\$
				\$
	O'head			\$
				\$

BACON

St. ~~Pl.~~ Ave. No. 11

Name of Owner
TAX ID # 302.20-21-18

Labor and Mat'l. Report 19

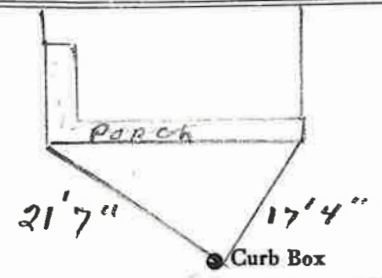

6 Main Elev. of Main at tap 5'-1
Gate at • Gate at •

• Curb Box