

LABOR AND MATERIALS


1	Copper	} Connection <u>3/4</u>	\$
	Lead		
1	Curb	} Cock Valve } <u>3/4</u> in.	\$
			T. S. & V.
1	Service box	} Short 3 1/2 x 4 1/2 } } Long 4 1/2 x 5 1/2 }	\$
	Old returned		
8	Ft. <u>3/4</u> in.	} Copper } } C.I. } } C.I. }	\$
	Nipples	in. at	\$
	Bushings	to in. at	\$
	Red'g } Inc'g }	Coupl'gs to in. at	\$
	Union	in. at	\$
	Meter	in. at	\$
	Lead Joints	at	\$
	Compound Joints	at	\$
	Maintenance Foreman		\$
	Hrs. Water Maint. Man-1	at	\$
	Hrs. Water Maint. Man-2	at	\$
	Hrs. Garage Foreman	at	\$
	Hrs. Labor	at	\$
	Hrs. Compressor	at	\$
	Compensation Ins.	at \$ per C	\$
	Trucking		\$
	Pav't Patch		\$
			\$
			\$
			\$
	O'head		\$
			\$

St. Pl. Ave. No. 12

BACON

Name of Owner
TAX ID # 302.20-22-14

Labor and Mat'l. Report 19

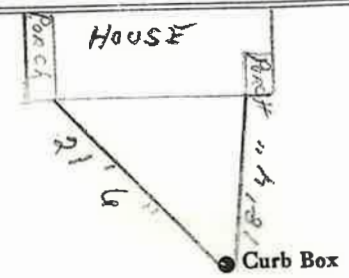

6 " Main Elev. of Main at tap 4 "

Gate at ● ● Gate at

● Curb Box