


LABOR AND MATERIALS

1	Copper	} Connection	3/4	_____	\$ _____	
	Lead					
1	Curb	} Cock Valve	3/4	in.	\$ _____	
	T.S. & V.					
1	Service box	} { Short 3 1/2 x 4 1/2 Long 4 1/2 x 5 1/2 Buff or Rdway }		_____	\$ _____	
	Old returned					
27	Pt.	} { Copper G.I. c.i. }		in.	Pipe at _____	\$ _____
	Nipples	_____ in.	at _____	\$ _____		
	Bushings	_____ to _____	in. at _____	\$ _____		
	Red'g	} Coupl'gs	_____ to _____	in. at _____	\$ _____	
	Inc'g					
	Union	_____ in.	at _____	\$ _____		
	Meter	_____ in.	at _____	\$ _____		
	Lead Joints	at _____	\$ _____			
	Compound Joints	at _____	\$ _____			
	Maintenance Foreman	_____	\$ _____			
	Hrs. Water Maint. Man-1	at _____	\$ _____			
	Hrs. Water Maint. Man-2	at _____	\$ _____			
	Hrs. Garage Foreman	_____ at _____	\$ _____			
	Hrs. Labor	_____ at _____	\$ _____			
	Hrs. Compressor	at _____	\$ _____			
	Compensation Ins.	at \$ _____ per C.	\$ _____			
	Trucking	_____	\$ _____			
	Pav't Patch	_____	\$ _____			
			\$ _____			
			\$ _____			
	O'head	_____	\$ _____			
			\$ _____			

BACON St. Pl. Ave. No. 7  
Name of Owner \_\_\_\_\_

Labor and Mat'l. Report 19

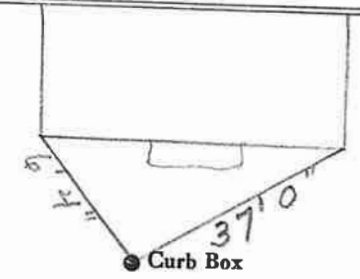

6" Main Elev. of Main at tap 5'  
Gate at • Gate at

TAX ID # 302.20-21-20

• Curb Box