

LABOR AND MATERIALS

| | | | | |
|----|-------------------------------|--|--------------------------|------------------------------|
| 1 | Copper Lead | } Connection | 3/4" | \$ |
| 1 | Curb | | | } Cook Valve T.S. & V. |
| 1 | Service box Old returned | } Short 3 1/2 x 4 1/2 Long 4 1/2 x 5 1/2 Buff or Rdway | | |
| 12 | Ft. 3/4 in. | | } Copper C.I. C.I. | } Pipe at |
| | Nipples in. at | | | |
| | Bushings to in. at | | \$ | |
| | Red'g } Inc'g } | } Coupl'gs. | to in. at | \$ |
| | Union in. at | | | \$ |
| | Meter in. at | \$ | | |
| | Lead Joints at | \$ | | |
| | Compound Joints at | \$ | | |
| | Maintenance Foreman | \$ | | |
| | Hrs. Water Maint. Man-1 at | \$ | | |
| | Hrs. Water Maint. Man-2 at | \$ | | |
| | Hrs. Garage Foreman at | \$ | | |
| | Hrs. Labor- at | \$ | | |
| | Hrs. Compressor at | \$ | | |
| | Compensation Ins. at \$ per C | \$ | | |
| | Trucking | \$ | | |
| | Pav't Patch | \$ | | |
| | O'head | \$ | | |

St.
Pl.
Ave. No. 10


BALOWIN

Name of Owner

TAX ID # 302.12-13-37.1

Labor and Mat'l. Report

19

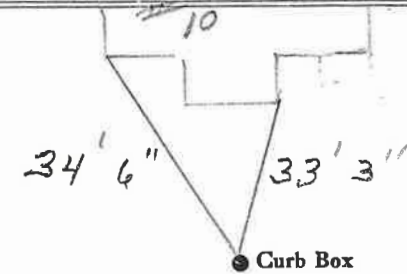

6" Main

Elev. of
Main at tap 5 1/2'

Gate at •

• Gate at

• Curb Box