

LABOR AND MATERIALS

1	Copper	} Connection	<u>3</u>	\$
	Lead			
1	Curb	} <u>3/4</u> in.	\$	
	Cock			
	Valve			
		T.S. & V.		
1	Service box	} <u>Short 3 1/2 x 4 1/2</u>	\$	
	Old returned			<u>Long 4 1/2 x 5 1/2</u>
				<u>Buff or Rdway</u>
10	Ft. <u>3/4</u> in.	} Pipe at	\$	
				<u>Copper</u>
		<u>G.I.</u>		
		<u>C.I.</u>		
	Nipples	in. at	\$	
	Bushings	to in. at	\$	
	Red'g	} Coupl'gs to in. at	\$	
	Inc'g			
	Union	in. at	\$	
	Meter	in. at	\$	
	Lead Joints at		\$	
	Compound Joints at		\$	
	Maintenance Foreman		\$	
	Hrs. Water Maint. Man—1 at		\$	
	Hrs. Water Maint. Man—2 at		\$	
	Hrs. Garage Foreman at		\$	
	Hrs. Labor— at		\$	
	Hrs. Compressor at		\$	
	Compensation Ins. at \$	per C	\$	
	Trucking		\$	
	Pav't Patch		\$	
			\$	
			\$	
	O'head		\$	
			\$	

BALDWIN


~~St.~~  
~~Pl.~~  
Ave. No. 40

Name of Owner

TAX ID # 302.12-13-51

Labor and Mat'l. Report

1981

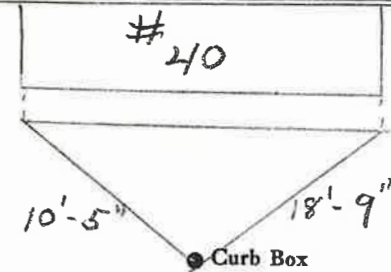

6 Main

Elev. of Main at tap 5

Gate at •

• Gate at

• Curb Box