


LABOR AND MATERIALS

1	Copper Lead	} Connection	3/4	\$
1	Curb			
1	Service box Old returned	} Short 3 1/2 x 4 1/2 Long 4 1/2 x 5 1/2 Buff or Rdway		\$
8	Ft. in.	} Copper C.I. C.I.	} Pipe at 3/4	\$
	Nipples	in. at		\$
	Bushings	to in. at		\$
	Red'g Inc'g	} Coupl'gs	to in. at	\$
	Union			
	Meter	in. at		\$
	Lead Joints	at		\$
	Compound Joints	at		\$
	Maintenance Foreman			\$
	Hrs. Water Maint. Man-1	at		\$
	Hrs. Water Maint. Man-2	at		\$
	Hrs. Garage Foreman	at		\$
	Hrs. Labor	at		\$
	Hrs. Compressor	at		\$
	Compensation Ins. at \$		per C	\$
	Trucking			\$
	Pav't Patch			\$
				\$
				\$
	O'head			\$
				\$

BALDWIN St. # Ave. No. 42

Name of Owner
TAX ID # 302.12-13-52

Labor and Mat'l. Report 19 81

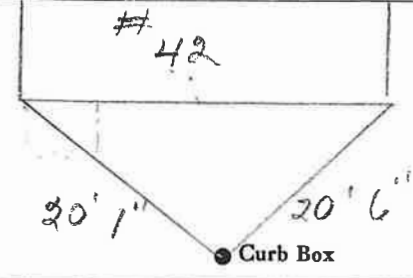

6 Main Elev. of Main at tap 4 1/2

Gate at ● ● Gate at

● Curb Box