

### LABOR AND MATERIALS

1	Copper } Lead }	Connection <u>3/4</u>	\$	
1	Curb } Valve }	T. S. & V. } <u>3/4 in.</u>	\$	
1	Service box } Old returned }	Short <u>3 1/2</u> x <u>4 1/2</u> Long <u>4 1/2</u> x <u>5 1/2</u> Buff or Rdway }	\$	
12	Fts <u>3/4</u> in. } Copper } C.I. }	Pipe at	\$	
	Nipples	in. at	\$	
	Bushings	to in. at	\$	
	Red'g } Inc'g }	Coupl'gs to in. at	\$	
	Union	in. at	\$	
	Meter	in. at	\$	
	Lead Joints	at	\$	
	Compound Joints	at	\$	
	Maintenance Foreman		\$	
	Hrs. Water Maint. Man-1	at	\$	
	Hrs. Water Maint. Man-2	at	\$	
	Hrs. Garage Foreman	at	\$	
	Hrs. Labor	at	\$	
	Hrs. Compressor	at	\$	
	Compensation Ins.	at \$ per C	\$	
	Trucking		\$	
	Pav't Patch		\$	
			\$	
			\$	
	O'head		\$	
			\$	


St. 42  
Pl. 44  
Ave. No. 44

BALDWIN

Name of Owner

Labor and Mat'l. Report

19

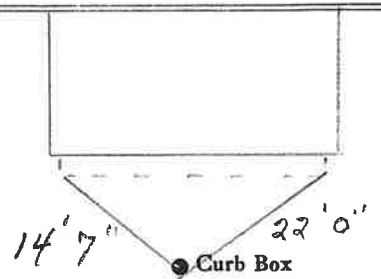

6 Main

Elev. of Main at tap 6

Gate at ●

● Gate at

● Curb Box