

LABOR AND MATERIALS

1	Copper Lead	Connection	<u>3/4</u>		\$
1	Curb	Cock Valve T.S. & V.	<u>3/4</u> in.		\$
1	Service box Old returned	Short 3 1/2 x 4 1/2 Long 4 1/2 x 5 1/2 Buff or Rdway			\$
9	Ft.	Copper C.I. C.I.	<u>3/4</u> in.	Pipe at	\$
	Nipples	in. at			\$
	Bushings	to in. at			\$
	Red'g Inc'g	Coupl'gs	to in. at		\$
	Union	in. at			\$
	Meter	in. at			\$
	Lead Joints	at			\$
	Compound Joints	at			\$
	Maintenance Foreman				\$
	Hrs. Water Maint. Man-1	at			\$
	Hrs. Water Maint. Man-2	at			\$
	Hrs. Garage Foreman	at			\$
	Hrs. Labor	at			\$
	Hrs. Compressor	at			\$
	Compensation Ins.	at \$	per C		\$
	Trucking				\$
	Pav't Patch				\$
					\$
					\$
	O'head				\$
					\$

St.
Pl.
Ave. No. 48


BALDWIN

Name of Owner

TAX ID # 302-12-13-56

Labor and Mat'l. Report

19 81

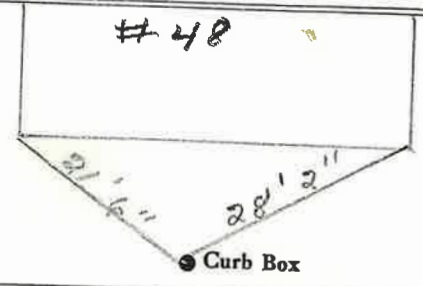

6 Main

Elev. of
Main at tap 6

Gate at ●

● Gate at

● Curb Box