


LABOR AND MATERIALS

1	Copper	} Connection	3/4	\$	
	Lead				
1	Curb	} T.S. & V.	3/4 in.	\$	
	Cock				
	Valve				
1	Service box	{	Short 3 1/2 x 4 1/2	\$	
	Old returned				Long 4 1/2 x 5 1/2
					Buff or Rdway
12	Ft. 3/4 in.	{	Copper	\$	
					G.I.
					C.I.
			Pipe at	\$	
	Nipples	in. at		\$	
	Bushings	to in. at		\$	
	Red'g	} Coupl'gs	to in. at	\$	
	Inc'g				
	Union	in. at		\$	
	Meter	in. at		\$	
	Lead Joints	at		\$	
	Compound Joints	at		\$	
	Maintenance Foreman			\$	
	Hrs. Water Maint. Man-1	at		\$	
	Hrs. Water Maint. Man-2	at		\$	
	Hrs. Garage Foreman	at		\$	
	Hrs. Labor	at		\$	
	Hrs. Compressor	at		\$	
	Compensation Ins. at \$	per C		\$	
	Trucking			\$	
	Pav't Patch			\$	
				\$	
				\$	
				\$	
	O'head			\$	
				\$	

BALDWIN St. Pl. Ave. No. 12

Name of Owner
TAX ID # 302.12-13-37.2

Labor and Mat'l. Report 19 81

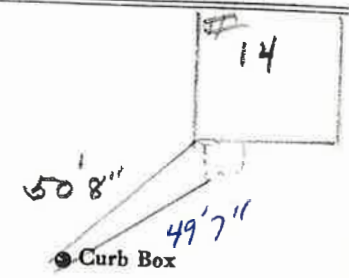

6" Main Elev. of Main at tap 5'
Gate at • Gate at

THIS TAP FOR #12 • Curb Box
BALDWIN AVE.
MEASURED FROM #14