


LABOR AND MATERIALS

1	Copper	} Connection	3/4	\$	
	Lead			\$	
1	Curb	} Cock } Valve } T.S. & V.	3/4 in.	\$	
1	Service box			} Short 3 1/2 x 4 1/2 } Long 4 1/2 x 5 1/2 } Buff or Rdway	\$
	Old returned				\$
7	Ft. 3/4 in.	} Copper } C.I. } C.I.	} Pipe at	\$	
	Nipples in. at			\$	
	Bushings to in. at	\$			
	Red'g } Inc'g } Coupl'gs to in. at	\$			
	Union in. at	\$			
	Meter in. at	\$			
	Lead Joints at	\$			
	Compound Joints at	\$			
	Maintenance Foreman	\$			
	Hrs. Water Maint. Man-1 at	\$			
	Hrs. Water Maint. Man-2 at	\$			
	Hrs. Garage Foreman at	\$			
	Hrs. Labor at	\$			
	Hrs. Compressor at	\$			
	Compensation Ins. at \$ per C	\$			
	Trucking	\$			
	Pav't Patch	\$			
		\$			
		\$			
		\$			
	O'head	\$			
		\$			

Baldwin St. ~~Pl.~~
Ave. No. 52

Name of Owner
TAX ID # 302.12-13-57

Labor and Mat'l. Report 19 81

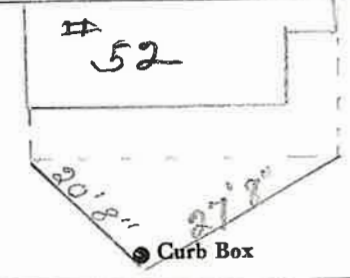

6" Main Elev. of Main at tap 5
Gate at • Gate at •

• Curb Box