

LABOR AND MATERIALS

1	Copper Lead	} Connection	$\frac{3}{4}$	\$		
1	Curb		} Cock Valve T.S. & V.	$\frac{3}{4}$ in.	\$	
1	Service box Old returned	} Short $3\frac{1}{2} \times 4\frac{1}{2}$ Long $4\frac{1}{2} \times 5\frac{1}{2}$ Buff or Rdway		$\frac{3}{4}$	\$	
10	Ft. $\frac{3}{4}$ in.		} Copper C.I. C.I.		Pipe at	\$
	Nipples				in. at	\$
	Bushings	to	in. at	\$		
	Red'g Inc'g	} Coupl'gs	to	in. at	\$	
	Union		in. at	\$		
	Meter	in. at	\$			
	Lead Joints	at	\$			
	Compound Joints	at	\$			
	Maintenance Foreman		\$			
	Hrs. Water Maint. Man	—1 at	\$			
	Hrs. Water Maint. Man	—2 at	\$			
	Hrs. Garage Foreman	at	\$			
	Hrs. Labor	at	\$			
	Hrs. Compressor	at	\$			
	Compensation Ins.	at \$	per C	\$		
	Trucking		\$			
	Pav't Patch		\$			
	O'head		\$			

St. A-B
Pl.
Ave. No. 30


BALDWIN

Name of Owner

TAX ID # 302.12-13-46

Labor and Mat'l. Report

19 81

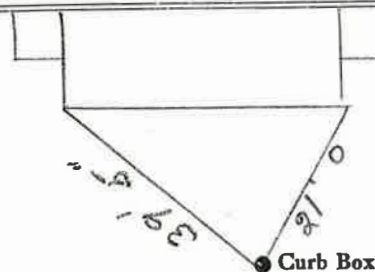

6 Main

Elev. of Main at tap $5\frac{1}{2}$

Gate at •

• Gate at

• Curb Box