


**Labor and Materials**

—	Copper } Connection.....	\$
—	Lead } .....	\$
1	Curb { Cock Valve T.S. & V. } in. 1"	\$
1	Service Box { Short 3 1/2 x 4 Old returned { Long 4 1/2 x 5 Buff. or Rdway }	\$
12	Ft. 1 1/4 in. { Copper Galv. Iron } Pipe at.....	\$
	Cast Iron } .....	\$
	Nipples..... in. at.....	\$
	Bushings..... to..... in. at.....	\$
2	Red'g } Couplings..... to..... in. at.....	\$
	Inc'g } .....	\$
	Union..... in. at.....	\$
	Meter..... in. at.....	\$
	Lbs. Br. Stone at.....	\$
	Lbs. Sand at.....	\$
	Bags Cement at.....	\$
	Paving Brick { Mack Red Asphalt } at.....	\$
	Lead Joints at.....	\$
	Leadite Joints at.....	\$
	Hrs. Foreman at.....	\$
	Hrs. Common Labor at.....	\$
	Hrs. Common Labor at.....	\$
	Hrs. Mason at.....	\$
	Hrs. Mason's Helper at.....	\$
	Hrs. Compressor at.....	\$
	Compensation Ins.....	\$
	Trucking.....	\$
	Builders' Use of Water.....	\$
	<b>Total \$.....</b>	

1" Tap & 1/4" Pipe for Pumping Station

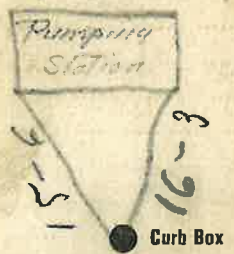

Sewer Pipe  
12" diam

	Main	Elev. of Main at tap
Gate at ●		● Gate at

● Curb Box

LABOR AND MATERIALS

1	Copper Lead	Connection	1"	\$
1	Curb	Cock Valve T.S. & V.	1 in. Oriseal	\$
1	Service box	Short 3 1/2 x 4 1/2		
	Old returned	Long 4 1/2 x 5 1/2		
		Buff or Rdway		\$
30	Ft. 1" in.	Copper C.I.	Pipe at	\$
	From main to			
70	Nipples	in. at	box.	\$
	Bushings	to in. at		\$
	Red'g Inc'g	Coupl'gs	to in. at	\$
	Union	in. at		\$
	Meter	in. at		\$
	Lead Joints at			\$
	Compound Joints at			\$
	Maintenance Foreman			\$
	Hrs. Water Maint. Man-1 at			\$
	Hrs. Water Maint. Man-2 at			\$
	Hrs. Garage Foreman	at		\$
	Hrs. Labor	at		\$
	Hrs. Compressor at			\$
	Compensation Ins. at \$	per C		\$
	Trucking			\$
	Pav't Patch			\$
	Tap by Gifford			\$
	Harbeau & Co.			\$
	11 - 66			\$
	O'head			\$

3 - 60' Coils 1" K. Cop.  
 1 - 40' Piece 1" K. Cop.,  
 3 - 1" Cop to Cop Couplings  
 Used from Curb box to  
 in Front of Building.

