


LABOR AND MATERIALS

1	Copper Lead	} Connection	3/4		\$
1	Curb	} Cock Valve T. S. & V.	3/4 in.		\$
1	Service box Old returned	{ Short 3 1/2 x 4 1/2 Long 4 1/2 x 5 1/2 Buff or Rdway			\$
20	Ft. in.	{ Copper G. I. C. I.	} Pipe at		\$
	Nipples	in. at			\$
	Bushings	to in. at			\$
	Red'g Inc'g	Coupl'gs to in. at			\$
	Union	in. at			\$
	Meter	in. at			\$
	Lead Joints at				\$
	Compound Joints at				\$
	Maintenance Foreman				\$
	Hrs. Water Maint. Man-1 at				\$
	Hrs. Water Maint. Man-2 at				\$
	Hrs. Garage Foreman at				\$
	Hrs. Labor at				\$
	Hrs. Compressor at				\$
	Compensation Ins. at \$	per C			\$
	Trucking				\$
	Pav't Patch				\$
					\$
					\$
	O'head				\$
					\$

St. PI.
Ave. No. 64

Name of Owner _____

Labor and Mat'l. Report 19

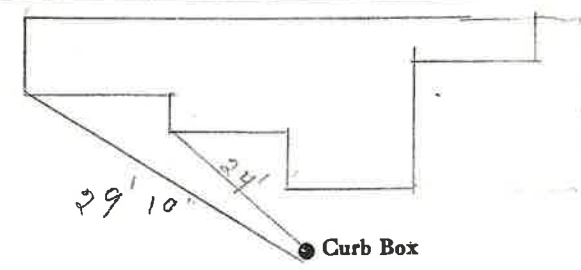

4 Main Elev. of Main at tap 5

Gate at • • Gate at

● Curb Box