

LABOR AND MATERIALS


1	Copper	} Connection	3/4	\$
	Lead			
1	Curb	} Valve	in.	\$
	T.S. & V.			
1	Service box	} { Short 3 1/2 x 4 1/2 Long 4 1/2 x 5 1/2 Buff or Rdway		\$
	Old returned			
14	Ft. in.	} Pipe at	3/4	\$
	Nipples	in. at		\$
	Bushings	to in. at		\$
	Red'g	} Coupl'gs	to in. at	\$
	Inc'g			
	Union	in. at		\$
	Meter	in. at		\$
	Lead Joints	at		\$
	Compound Joints	at		\$
	Maintenance Foreman			\$
	Hrs. Water Maint. Man	1 at		\$
	Hrs. Water Maint. Man	2 at		\$
	Hrs. Garage Foreman	at		\$
	Hrs. Labor	at		\$
	Hrs. Compressor	at		\$
	Compensation Ins.	at \$ per C		\$
	Trucking			\$
	Pav't Patch			\$
				\$
				\$
	O'head			\$
				\$

St. Fl.  
Ave. No. 179

BAY

Name of Owner  
TAX ID # 302.12-18-10

Labor and Mat'l. Report 19

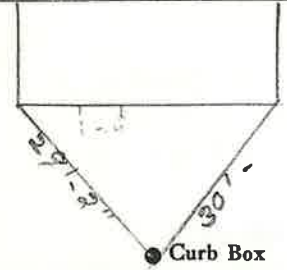

6" Main

Elev. of Main at tap 5'

Gate at ● ● Gate at

30.0 TAP 30.0 0.18  
● Curb Box