

LABOR AND MATERIALS

Copper	} Connection	_____	\$ _____	
Lead				
Curb	} Cock } Valve } T. S. & V. }	_____ in.	\$ _____	
Service box		} Short 3½ x 4½ }		
Old returned			} Long 4½ x 5½ }	
Ft. _____ in.	} Copper } G. I. } C. I. }	Pipe at _____	\$ _____	
Nipples _____ in.		at _____	\$ _____	
Bushings _____ to _____ in.		at _____	\$ _____	
Red'g } Inc'g }	} Coupl'gs _____ to _____ in.	at _____	\$ _____	
Union _____ in.		at _____	\$ _____	
Meter _____ in.	at _____	\$ _____		
_____			\$ _____	
Compound Joints	at _____	\$ _____		
Maintenance Foreman		\$ _____		
Hrs. Water Maint. Man—1	at _____	\$ _____		
Hrs. Water Maint. Man—2	at _____	\$ _____		
Hrs. Garage Foreman	at _____	\$ _____		
Hrs. Labor—	at _____	\$ _____		
Hrs. Compressor	at _____	\$ _____		
_____			\$ _____	
Trucking		\$ _____		
Pav't Patch		\$ _____		
_____			\$ _____	
_____			\$ _____	
_____			\$ _____	
_____			\$ _____	


LOT TAP

BAY

St. ~~Pl.~~
Ave. No. 197

Name of Owner _____

Labor and Mat'l. Report JUNE 1936

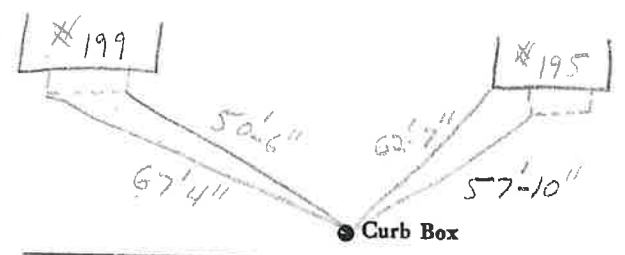

Main _____ Elev. of Main at tap _____
Gate at • _____ • Gate at _____

• Curb Box