

LABOR AND MATERIALS

1	Copper	} Connection	3/4"	_____	\$ _____
	Lead				
1	Curb	} Cock Valve P.S. & V.	} 3/4" in.	_____	\$ _____
1	Service box	} Short 3 1/2 x 4 1/2	} Long 4 1/2 x 5 1/2	_____	\$ _____
	Old returned				
26	Ft. 3/4 in.	} Copper	} Pipe at _____	_____	\$ _____
	Nipples	in. at _____			\$ _____
	Bushings	to _____ in. at _____			\$ _____
	Red'g } Inc'g	} Coupl'gs	to _____ in. at _____	_____	\$ _____
	Union	in. at _____			\$ _____
	Meter	in. at _____			\$ _____
					\$ _____
	Compound Joints	at _____			\$ _____
	Maintenance Foreman				\$ _____
	Hrs. Water Maint. Man—1	at _____			\$ _____
	Hrs. Water Maint. Man—2	at _____			\$ _____
	Hrs. Garage Foreman	at _____			\$ _____
	Hrs. Labor—	at _____			\$ _____
	Hrs. Compressor	at _____			\$ _____
					\$ _____
	Trucking				\$ _____
	Pav't Patch				\$ _____
					\$ _____
					\$ _____
					\$ _____
					\$ _____

ALSO CALLED 1/2 LEXINGTON AVE


RAY

St. REAR
Pl:
Ave. No. 201

Name of Owner

Labor and Mat'l. Report

SEPT. 19 25

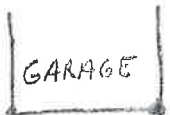

33' 40'6"

● Curb Box

6" Main

Elev. of Main at tap 6'

Gate at ●

● Gate at

26' to main

● Curb Box

TAP ON LEXINGTON


LABOR AND MATERIALS

Copper	}	Connection		\$	
Lead					
Curb	}	Cock	in.	\$	
		Valve			
		T. S. & V.			
Service box	}	Short 3½ x 4½		\$	
Old returned		Long 4½ x 5½			
		Buff or Rdway			
26 Ft. ¾ in.	}	Copper	Pipe at	\$	
		G.I.			
		G.I.			
Nipples		in. at		\$	
Bushings		to in. at		\$	
Red'g	}	Coupl'gs	to in. at	\$	
Inc'g					
Union		in. at		\$	
Meter		in. at		\$	
Lead Joints at				\$	
Compound Joints at				\$	
Maintenance Foreman				\$	
Hrs. Water Maint. Man—1 at				\$	
Hrs. Water Maint. Man—2 at				\$	
Hrs. Garage Foreman at				\$	
Hrs. Labor— at				\$	
Hrs. Compressor at				\$	
Compensation Ins. at \$		per C		\$	
Trucking				\$	
Pav't Patch				\$	
				\$	
				\$	
O'head				\$	

St.
~~Pl.~~
Ave. No. 201

Name of Owner

Labor and Mat'l. Report 1986

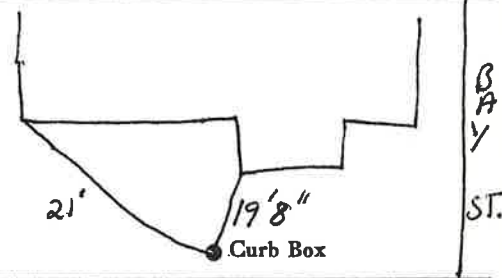

LEXINGTON AVE.

Main Elev. of
Main at tap Main at tap

Gate at ● ● Gate at
26' to main

● Curb Box

Tap on Lexington


LABOR AND MATERIALS

Copper	Lead	Connection			\$
	}	Cock	in.	\$	
Curb		Valve			
		T.S. & V.			
Service box	}	Short 3½ x 4½			\$
Old returned		Long 4½ x 5½			
		Buff or Rdway			
26 Ft.	}	Copper	Pipe at	\$	
¾ in.		G.I.			
		G.I.			
Nipples	in.	at		\$	
Bushings	to	in.	at		\$
Red'g	}	Coupl'gs	to	in.	at
Inc'g					
Union	in.	at		\$	
Meter	in.	at		\$	
Lead Joints at				\$	
Compound Joints at				\$	
Maintenance Foreman				\$	
Hrs. Water Maint. Man—1 at				\$	
Hrs. Water Maint. Man—2 at				\$	
Hrs. Garage Foreman		at		\$	
Hrs. Labor—		at		\$	
Hrs. Compressor at				\$	
Compensation Ins. at \$		per C		\$	
Trucking				\$	
Pav't Patch				\$	
				\$	
				\$	
O'head				\$	
				\$	

St.
~~Pt.~~
Ave. No. 201

Name of Owner

Labor and Mat'l. Report 1986

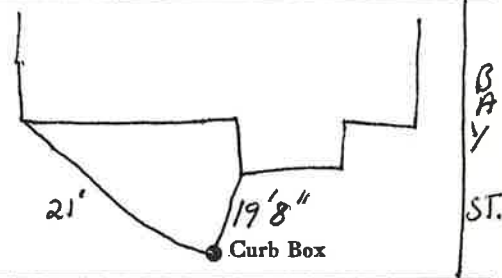

LEXINGTON AVE.

Main Elev. of
Main at tap

Gate at ● ● Gate at
26' to main

● Curb Box

Tap on Lexington