

LABOR AND MATERIALS

1	Copper Lead } Connection	3/4		\$ 2.80
1	Curb { Clock Valve } T. S. & V. }	3/4 in.		\$ 3.60
1	Service box Old returned	Short 3 1/2 X 4 1/2 } Long 4 1/2 X 5 1/2 } Buff or Rdway		\$ 5.80
34	Ft.	3/4 in.	Copper Galv. Iron Cast Iron } Pipe at	35 \$ 11.90
	Nipples in. at		\$
	Bushings to in. at	\$
	Red'g Inc'g } Couplings to in. at	\$
	Union in. at		\$
	Meter in. at		\$
	Lead Joints	at		\$
	Compound Joints	at		\$
	Hrs. Foreman	at		\$
	Hrs. Chauffeur	at		\$
14	Hrs. Tapper	at	.91	\$ 12.74
2.8	Hrs. Labor	at	.80	\$ 2.24
	Hrs. Labor	at		\$
	Hrs. Compressor	at		\$
	Compensation Ins.			\$ 1.78
	Trucking			\$ 7.80
	Builders Use of Water			\$ 7.80
	<i>copy Maguire</i>			\$
				\$
				\$
				\$
				\$
				\$ 6.862


117-47

St.
Pl. Ave. No. *220*

Bay St

Name of Owner
Girard

Labor and Mat'l. Report *Aug 21* 19 *47*

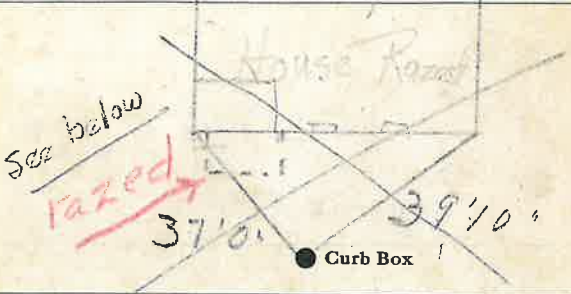

6 Main Elev. of Main at tap *4 1/2*

Gate at ● Gate at ●

