


LABOR AND MATERIALS

Copper	} Connection	_____	\$ _____	
Lead				
Curb	} Cock Valve T. S. & V.	_____ in.	\$ _____	
Service box		} Short 3 1/2 x 4 1/2 } Long 4 1/2 x 5 1/2 }	_____	\$ _____
Old returned				
Ft. <i>3/4</i> in.	} Copper } } G. I. } } G. I. }	Pipe at _____	\$ _____	
Nipples		_____ in. at _____	\$ _____	
Bushings	_____ to _____ in. at _____	\$ _____		
Red'g } Inc'g }	} Coupl'gs	_____ to _____ in. at _____	\$ _____	
Union		_____ in. at _____	\$ _____	
Meter	_____ in. at _____	\$ _____		
Compound Joints	at _____	\$ _____		
Maintenance Foreman	_____	\$ _____		
Hrs. Water Maint. Man-1	at _____	\$ _____		
Hrs. Water Maint. Man-2	at _____	\$ _____		
Hrs. Garage Foreman	at _____	\$ _____		
Hrs. Labor	_____ at _____	\$ _____		
Hrs. Compressor	at _____	\$ _____		
Trucking	_____	\$ _____		
Pav't Patch	_____	\$ _____		
		\$ _____		
		\$ _____		
St. *Bay (+ Ft. Amherst)*
Pl. Ave. No. *230*

Name of Owner
Barlow

Labor and Mat'l. Report 19 *88*

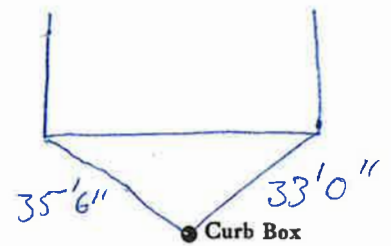

Ft. Amherst Rd.

Main Elev. of Main at tap _____

Gate at • • Gate at

TAX ID # 302.12-2-1

● Curb Box