

LABOR AND MATERIALS


/	Copper Lead	Connection	3/4		\$						
/	Curb	Cock Valve T.S. & V.	3/4 in.		\$						
/	Service box Old returned	<table border="0" style="font-size: small;"> <tr><td>Short</td><td>3 1/2 x 4 1/2</td></tr> <tr><td>Long</td><td>4 1/2 x 5 1/2</td></tr> <tr><td>Buff or Rdway</td><td></td></tr> </table>	Short	3 1/2 x 4 1/2	Long	4 1/2 x 5 1/2	Buff or Rdway				\$
Short	3 1/2 x 4 1/2										
Long	4 1/2 x 5 1/2										
Buff or Rdway											
8	Ft.	3/4 in.	<table border="0" style="font-size: small;"> <tr><td>Copper</td></tr> <tr><td>C.I.</td></tr> <tr><td>C.I.</td></tr> </table>	Copper	C.I.	C.I.	} Pipe at	\$			
Copper											
C.I.											
C.I.											
	Nipples	in. at			\$						
	Bushings	to in. at			\$						
	Red'g Inc'g	Coupl'gs. to in. at			\$						
	Union	in. at			\$						
	Meter	in. at			\$						
	Lead Joints	at			\$						
	Compound Joints	at			\$						
	Maintenance Foreman				\$						
	Hrs. Water Maint. Man-1	at			\$						
	Hrs. Water Maint. Man-2	at			\$						
	Hrs. Garage Foreman	at			\$						
	Hrs. Labor	at			\$						
	Hrs. Compressor	at			\$						
	Compensation Ins.	at \$ per C			\$						
	Trucking				\$						
	Pav't Patch				\$						
					\$						
					\$						
					\$						
	O'head				\$						
					\$						

St.
Pl.
Ave. No. 76

BAY

Name of Owner _____

Labor and Mat'l. Report 19

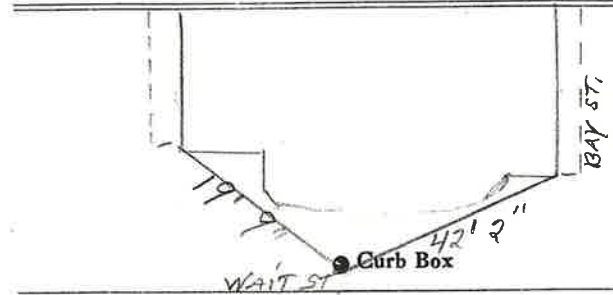

Elev. of Main at tap 5'

6 Main WAIT ST.

Gate at ● ● Gate at

● Curb Box