

LABOR AND MATERIALS


1	Copper } Lead }	Connection <u>3/4</u>	\$	
1	Curb } T.S. & V. }	Cock Valve } in. <u>3/4</u>	\$	
1	Service box } Old returned }	Short $3\frac{1}{2} \times 4\frac{1}{2}$ } Long $4\frac{1}{2} \times 5\frac{1}{2}$ } Buff or Rdway }	\$	
35	Ft. <u>3/4</u> in.	Copper } G. I. } C. I. }	\$	Pipe at
	Nipples	in. at	\$	
	Bushings	to in. at	\$	
	Red'g } Inc'g }	Coupl'gs	to in. at	\$
	Union	in. at	\$	
	Meter	in. at	\$	
	Lead Joints	at	\$	
	Compound Joints	at	\$	
	Maintenance Foreman		\$	
	Hrs. Water Maint. Man	1 at	\$	
	Hrs. Water Maint. Man	2 at	\$	
	Hrs. Garage Foreman	at	\$	
	Hrs. Labor	at	\$	
	Hrs. Compressor	at	\$	
	Compensation Ins.	at \$ per C	\$	
	Trucking		\$	
	Pav't Patch		\$	
			\$	
			\$	
			\$	
	O'head		\$	
			\$	

St. 78
Pl. 78
Ave. No. 78

BAY

Name of Owner _____

Labor and Mat'l. Report 19 81

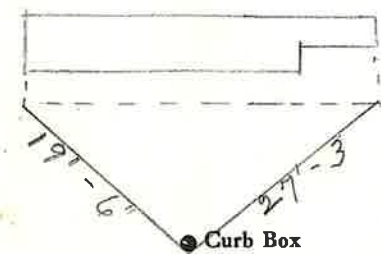

10 Main Elev. of Main at tap 4 1/2

Gate at • • Gate at

• Curb Box