


LABOR AND MATERIALS

1	Copper Lead	Connection	$\frac{3}{4}$	\$	
1	Curb	Cock Valve T.S. & V.	$\frac{3}{4}$ in.	\$	
1	Service box Old returned	Short $3\frac{1}{2} \times 4\frac{1}{2}$ Long $4\frac{1}{2} \times 5\frac{1}{2}$ Buff or Rdway		\$	
11	Ft.	$\frac{3}{4}$ in.	Copper C.I. C.I.	Pipe at	\$
	Nipples	in.	at	\$	
	Bushings	to	in.	at	\$
	Red'g Inc'g	Coupl'gs	to	in.	at
	Union	in.	at	\$	
	Meter	in.	at	\$	
	Lead Joints	at		\$	
	Compound Joints	at		\$	
	Maintenance Foreman			\$	
	Hrs. Water Maint. Man	1	at	\$	
	Hrs. Water Maint. Man	2	at	\$	
	Hrs. Garage Foreman		at	\$	
	Hrs. Labor		at	\$	
	Hrs. Compressor	at		\$	
	Compensation Ins.	at \$	per C	\$	
	Trucking			\$	
	Pav't Patch			\$	
				\$	
				\$	
				\$	
	O'head			\$	
				\$	

St. Pl. Ave. No. 79

BAY
Name of Owner

Labor and Mat'l. Report 19 81

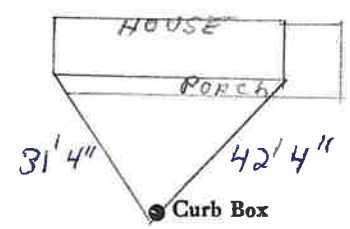

10 " Main Elev. of Main at tap 5'

Gate at • Gate at

• Curb Box