


LABOR AND MATERIALS

1	Copper Lead	} Connection $1\frac{1}{2}$ "	\$	
1	Curb Valve T-S. & V.		} $1\frac{1}{2}$ in.	\$
1	Service box Old returned	} Short $3\frac{1}{2} \times 4\frac{1}{2}$ Long $4\frac{1}{2} \times 5\frac{1}{2}$ Buff on Rdway		\$
37	Ft. $1\frac{1}{2}$ in.		} Copper G.I. Pipe at	\$
	Nipples	in. at	\$	
	Bushings	to in. at	\$	
	Red'g } Inc'g }	Coupl'gs to in. at	\$	
	Union	in. at	\$	
	Meter	in. at	\$	
	Lead Joints	at	\$	
	Compound Joints	at	\$	
	Maintenance Foreman		\$	
	Hrs. Water Maint. Man-1	at	\$	
	Hrs. Water Maint. Man-2	at	\$	
	Hrs. Garage Foreman	at	\$	
	Hrs. Labor	at	\$	
	Hrs. Compressor	at	\$	
	Compensation Ins.	at \$ per C	\$	
	Trucking		\$	
	Pav't Patch		\$	
			\$	
			\$	
	O'head		\$	
			\$	

St. PI.  
BAY Ave. No. 84

Name of Owner  
CUMBERLANDS

Labor and Mat'l. Report 19

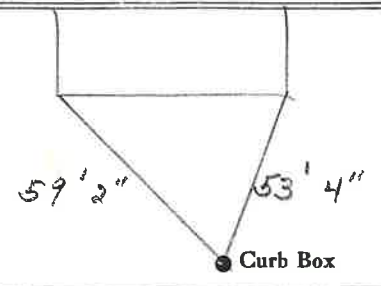

10 Main Elev. of Main at tap 5'  
 Gate at • Gate at •

• Curb Box