

LABOR AND MATERIALS


1 Copper } Connection $\frac{3}{4}$ " \$
 Lead }
 1 Curb } Cock } $\frac{3}{4}$ " in. Oriseal \$
 } Valve }
 } T:S:&V: }
 1 Service box { Short $3\frac{1}{2}$ x $4\frac{1}{2}$ }
 Old returned { Long $4\frac{1}{2}$ x $5\frac{1}{2}$ } \$
 { Buff or Rdway }
 10 Ft. $\frac{3}{4}$ in. { Copper } Pipe at \$
 { G.I. }
 { C.I. }
 Nipples _____ in. at \$
 Bushings _____ to _____ in. at \$
 Red'g }
 Inc'g } Coupl'gs _____ to _____ in. at \$
 Union _____ in. at \$
 Meter _____ in. at \$
 Lead Joints at \$
 Compound Joints at \$
 Maintenance Foreman \$
 Hrs. Water Maint. Man-1 at \$
 Hrs. Water Maint. Man-2 at \$
 Hrs. Garage Foreman _____ at \$
 Hrs. Labor _____ at \$
 Hrs. Compressor at \$
 Compensation Ins. at \$ _____ per C \$
 Trucking \$
 Pav't Patch \$
 Tap by Donovan + Co. \$
 11-23-70. \$
 O'head \$
 \$

St. _____
 Pl. _____
 Ave. No. 89

Bay

Name of Owner Bentley

Labor and Mat'l. Report Nov. 23 19 70

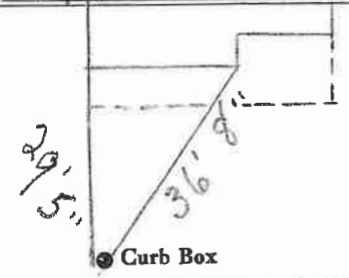

10" Main Elev. of Main at tap 5 1/2'

Gate at • Gate at

• Curb Box