

## LABOR AND MATERIALS


1	Copper Lead } Connection	<u>3/4</u>	\$	2.80
1	Curb } Clock Valve (7-8-8; V.)	<u>3/4</u> in.	\$	3.60
1	Service box Old returned	{ Short 3 1/2 X 4 1/2 Long 4 1/2 X 5 1/2 Buff or Rdway }	\$	5.80
<u>36</u>	Ft. <u>3/4</u> in. } Copper Galv. Iron Cast Iron	Pipe at <u>35</u>	\$	12.60
	Nipples	in. at .....	\$	
	Bushings	to ..... in. at .....	\$	
	Red'g Inc'g	Couplings to ..... in. at .....	\$	
	Union	in. at .....	\$	
	Meter	in. at .....	\$	
	Lead Joints	at .....	\$	
	Compound Joints	at .....	\$	
<u>12</u>	Hrs. Foreman at	<u>W.W.M. 9 2 1/2</u>	\$	11.10
<u>6</u>	Hrs. Chauffeur at	<u>8 2 1/2</u>	\$	4.95
	Hrs. Tapper at		\$	
<u>13</u>	Hrs. Labor at	<u>7 1/2</u>	\$	9.30
	Hrs. Labor at		\$	
	Hrs. Compressor at		\$	
	Compensation Ins.		\$	<u>60</u>
	Trucking		\$	<u>1</u>
	Builders Use of Water.		\$	
	<u>Tap by Miller</u>		\$	
			\$	
			\$	
			\$	
				\$ <u>51.75</u>

37

St.  
Pt. Bay  
Ave. No. 90

Name of Owner  
Grant

Labor and Mat'l. Report Apr 23 19 47

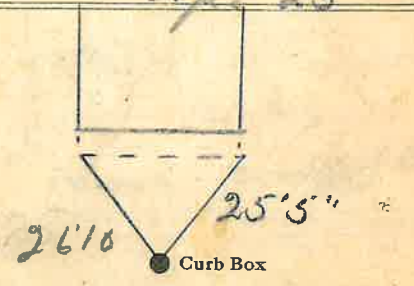

10 Main Elev. of  
Main at tap 5-

Gate at ● ● Gate at

● Curb Box

LSM-5C-6-1-45

To be billed ✓