


LABOR AND MATERIALS

1	Copper Leads	Connection	$\frac{3}{4}$	\$	
1	Curb	Cock Valve T.S. & V.	$\frac{3}{4}$ in.	\$	
1	Service box Old returned	Short $3\frac{1}{2}$ x $4\frac{1}{2}$ Long $4\frac{1}{2}$ x $5\frac{1}{2}$ Buff or Rdway		\$	
34	Ft.	Copper C.I. C.I.	$\frac{3}{4}$ in. } Pipe at	\$	
	Nipples	in. at		\$	
	Bushings	to in. at		\$	
	Red'g Inc'g	Coupl'gs to in. at		\$	
	Union	in. at		\$	
	Meter	in. at		\$	
	Lead Joints	at		\$	
	Compound Joints	at		\$	
	Maintenance Foreman			\$	
	Hrs. Water Maint. Man	1 at		\$	
	Hrs. Water Maint. Man	2 at		\$	
	Hrs. Garage Foreman	at		\$	
	Hrs. Labor	at		\$	
	Hrs. Compressor	at		\$	
	Compensation Ins.	at \$ per C		\$	
	Trucking			\$	
	Pav't Patch			\$	
				\$	
				\$	
	O'head			\$	
				\$	

St. Pl. Ave. No. 92
BAV

Name of Owner

Labor and Mat'l. Report 19

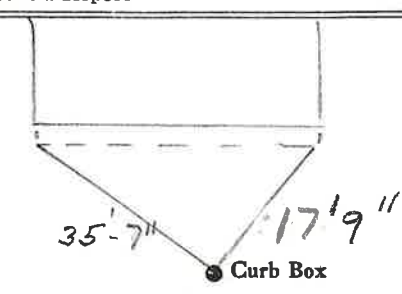

10 Main Elev. of Main at tap 5

Gate at • Gate at •

• Curb Box