


LABOR AND MATERIALS

1	Copper	Connection	3/4	\$
1	Lead	Cook Valve	3/4 in.	\$
		T.S. & V.		
1	Service box	Short 3 1/2 x 4 1/2		
	Old returned	Long 4 1/2 x 5 1/2		
		Buff or Rdway		\$
10	Ft.	Copper		
	in.	G.I.	Pipe at	\$
		G.I.		
	Nipples	in.	at	\$
	Bushings	to	in. at	\$
	Red'g			
	Inc'g	Coupl'gs	to in. at	\$
	Union	in.	at	\$
	Meter	in.	at	\$
	Lead Joints			\$
	Compound Joints			\$
	Maintenance Foreman			\$
	Hrs. Water Maint. Man	1	at	\$
	Hrs. Water Maint. Man	2	at	\$
	Hrs. Garage Foreman		at	\$
	Hrs. Labor		at	\$
	Hrs. Compressor		at	\$
	Compensation Ins.		at \$ per C	\$
	Trucking			\$
	Pav't Patch			\$
				\$
				\$
	O'head			\$
				\$

St. Pl. Ave. No. 95
 BAY

Name of Owner
 TAX ID # 302.20-9-15

Labor and Mat'l. Report 19

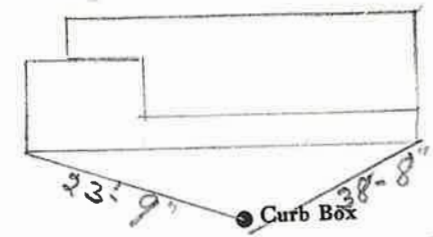

10 Main Elev. of Main at tap 4 1/2
 Gate at • Gate at

• Curb Box