

LABOR AND MATERIALS


| | | | | | | |
|----|-----------------------------|--|----------------|--|----|--|
| 1 | Copper } Lead | Connection | <u>3/4</u> | | \$ | |
| 1 | Curb | Cock Valve T.S. & V. | <u>3/4</u> in. | | \$ | |
| 1 | Service box Old returned | Short $3\frac{1}{2} \times 4\frac{1}{2}$ Long $4\frac{1}{2} \times 5\frac{1}{2}$ Buff or Rdway | | | \$ | |
| 12 | Ft. <u>3/4</u> in. | Copper } C.I. C.I. | Pipe at | | \$ | |
| | Nipples | in. at | | | \$ | |
| | Bushings | to in. at | | | \$ | |
| | Red'g } Inc'g } | Coupl'gs | to in. at | | \$ | |
| | Union | in. at | | | \$ | |
| | Meter | in. at | | | \$ | |
| | Lead Joints | at | | | \$ | |
| | Compound Joints | at | | | \$ | |
| | Maintenance Foreman | | | | \$ | |
| | Hrs. Water Maint. Man-1 | at | | | \$ | |
| | Hrs. Water Maint. Man-2 | at | | | \$ | |
| | Hrs. Garage Foreman | at | | | \$ | |
| | Hrs. Labor | at | | | \$ | |
| | Hrs. Compressor | at | | | \$ | |
| | Compensation Ins. | at \$ | per C | | \$ | |
| | Trucking | | | | \$ | |
| | Pav't Patch | | | | \$ | |
| | | | | | \$ | |
| | | | | | \$ | |
| | | | | | \$ | |
| | O'head | | | | \$ | |
| | | | | | \$ | |

St.
Pl.
Ave. No. 101

BAY

Name of Owner _____
TAX ID # 302.16-20-18

Labor and Mat'l. Report 19

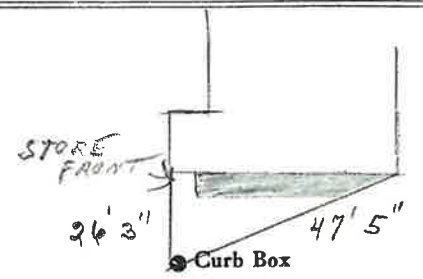

10 Main Elev. of Main at tap 5

Gate at ● ● Gate at

● Curb Box