

### LABOR AND MATERIALS


1	Copper	} Connection	1"		\$
	Lead				
1	Curb	} Cock	1"		\$
		} Valve			
		} T.S. & V.			
1	Service box	}	Short 3 1/2 x 4 1/2	1"	\$
	Old returned		Long 4 1/2 x 5 1/2		
			Buff. or Rdway		
36 Ft.	1"	}	Copper	}	\$
			G.I.		
			G.I.		
	Nipples		in. at		\$
	Bushings		to in. at		\$
	Red'g	}	Coupl'gs	to in. at	\$
	Inc'g				
	Union		in. at		\$
	Meter		in. at		\$
	Lead Joints		at		\$
	Compound Joints		at		\$
	Maintenance Foreman				\$
	Hrs. Water Maint. Man—1		at		\$
	Hrs. Water Maint. Man—2		at		\$
	Hrs. Garage Foreman		at		\$
	Hrs. Labor		at		\$
	Hrs. Compressor		at		\$
	Compensation Ins. at \$		per C		\$
	Trucking				\$
	Pav't Patch				\$
					\$
					\$
	O'head				\$
					\$

St.  
Pl.  
Ave. No. 33

Name of Owner

Labor and Mat'l. Report

19 81

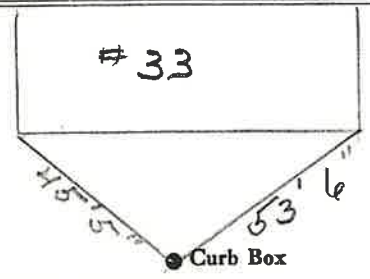

10"  
12" Main

Elev. of  
Main at tap 5 1/2

Gate at •

• Gate at

• Curb Box