

LABOR AND MATERIALS


1	Copper Lead	Connection	3/4	\$	
1	Curb	Cock Valve T.S. & V.	3/4 in.	\$	
1	Service box Old returned	Short 3 1/2 x 4 1/2 Long 4 1/2 x 5 1/2 Buff or Rdway		\$	
13	Ft. in.	Copper C.I. C.I.	Pipe at	\$	
	Nipples	in. at		\$	
	Bushings	to in. at		\$	
	Red'g Inc'g	Coupl'gs to in. at		\$	
	Union	in. at		\$	
	Meter	in. at		\$	
	Lead Joints at			\$	
	Compound Joints at			\$	
	Maintenance Foreman			\$	
	Hrs. Water Maint. Man-1 at			\$	
	Hrs. Water Maint. Man-2 at			\$	
	Hrs. Garage Foreman at			\$	
	Hrs. Labor-	at		\$	
	Hrs. Compressor at			\$	
	Compensation Ins. at \$	per C		\$	
	Trucking			\$	
	Pav't Patch			\$	
	O'head			\$	

St. Pl. Ave. No. 111

BAY

Name of Owner
TAX ID # 302.16-20-13

Labor and Mat'l. Report 19

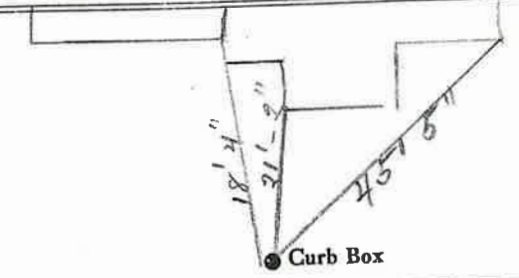

4 GAL. Main Elev. of Main at tap 4 1/2

Gate at • Gate at •

• Curb Box
TAP ON GRAND ST.