


LABOR AND MATERIALS

1	Copper } Connection	$\frac{3}{4}$	\$	
	Lead }			
1	Curb } Cock	in. $\frac{3}{4}$	\$	
	Valve }			
	T.S. & V. }			
1	Service box	{ Short $3\frac{1}{2} \times 4\frac{1}{2}$	\$	
	Old returned	{ Long $4\frac{1}{2} \times 5\frac{1}{2}$		
		{ Buff or Rdway }		
9	Ft. in. } Copper	Pipe at $\frac{3}{4}$	\$	
				{ G. I. }
				{ G. I. }
	Nipples	in. at	\$	
	Bushings	to in. at	\$	
	Red'g } Coupl'gs	to in. at	\$	
	Inc'g }			
	Union	in. at	\$	
	Meter	in. at	\$	
	Lead Joints	at	\$	
	Compound Joints	at	\$	
	Maintenance Foreman		\$	
	Hrs. Water Maint. Man-1	at	\$	
	Hrs. Water Maint. Man-2	at	\$	
	Hrs. Garage Foreman	at	\$	
	Hrs. Labor	at	\$	
	Hrs. Compressor	at	\$	
	Compensation Ins.	at \$ per C	\$	
	Trucking		\$	
	Pav't Patch		\$	
			\$	
			\$	
			\$	
	O'head		\$	
			\$	

BAY ST. St. Pl. Ave. No. 115

Name of Owner TAX ID # 302.16-17-31

Labor and Mat'l. Report 19

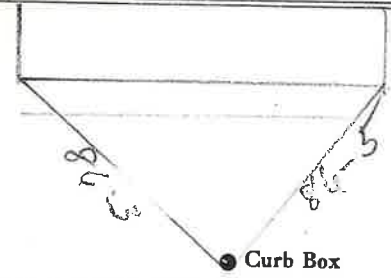

6 Main Elev. of Main at tap 5
 Gate at ● Gate at ●

● Curb Box