


LABOR AND MATERIALS

Copper	} Connection	_____	\$		
Lead		_____	\$		
Curb	} Cock	_____ in.	\$		
				} Valve	_____
Service box	} Short 3½ x 4½	_____	\$		
Old returned				} Long 4½ x 5½	_____
32 Ft. 1" in.	} Copper	} Pipe at	\$		
				} G.I.	_____
Nipples	_____ in. at	_____	\$		
Bushings	_____ to _____ in. at	_____	\$		
Red'g	} Coupl'gs	_____ to _____ in. at	\$		
Inc'g				_____	
Union	_____ in. at	_____	\$		
Meter	_____ in. at	_____	\$		
Lead Joints	_____ at	_____	\$		
Compound Joints	_____ at	_____	\$		
Maintenance Foreman	_____ at	_____	\$		
Hrs. Water Maint. Man-1	_____ at	_____	\$		
Hrs. Water Maint. Man-2	_____ at	_____	\$		
Hrs. Garage Foreman	_____ at	_____	\$		
Hrs. Labor	_____ at	_____	\$		
Hrs. Compressor	_____ at	_____	\$		
Compensation Ins. at \$	_____ per C	_____	\$		
Trucking	_____	_____	\$		
Pav't Patch	_____	_____	\$		
			\$		
			\$		
			\$		
			\$		
O'head	_____	_____	\$		
			\$		

Bay St St.
 Pt. Ave. No. 116
 Name of Owner
 TAX ID # 302.16-12-2

Labor and Mat'l. Report 19

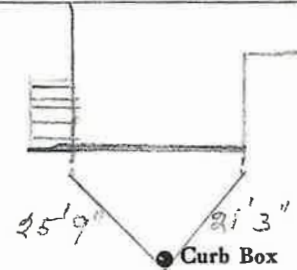

6 Main Elev. of Main at tap 5
 Gate at • Gate at

• Curb Box

NOTE - THERE IS ANOTHER HOUSE ON REAR OF THIS PROPERTY - ADDRESS #116 1/2 -

LSM-5C-6-1-67

THIS 1" SERVICE FEEDS BOTH HOUSES