


LABOR AND MATERIALS

1	Copper } Connection		\$
	Lead }		
1	Curb } Cock		\$
	Valve }	in.	
	T. S. & V. }		
1	Service box } Short 3 1/2 x 4 1/2		\$
	Old returned. } Long 4 1/2 x 5 1/2		
		Buff. or Rdway.	
9	Ft. 9 in. } Copper	Pipe at	\$
		G.I.	
		C.I.	
	Nipples	in. at	\$
	Bushings	to in. at	\$
	Red'g } Coupl'gs	to in. at	\$
	Inc'g }		
	Union	in. at	\$
	Meter	in. at	\$
	Lead Joints	at	\$
	Compound Joints	at	\$
	Maintenance Foreman		\$
	Hrs. Water Maint. Man-1	at	\$
	Hrs. Water Maint. Man-2	at	\$
	Hrs. Garage Foreman	at	\$
	Hrs. Labor	at	\$
	Hrs. Compressor	at	\$
	Compensation Ins. at \$	per C	\$
	Trucking		\$
	Pav't Patch		\$
			\$
			\$
			\$
	O'head		\$
			\$

5/14/80
 117 BAY
 St.
 Pl.
 Ave. No.

Name of Owner

Labor and Mat'l. Report *3/14 19 80*

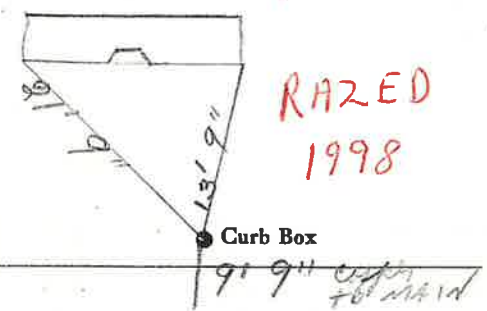

Main
 Elev. of Main at tap
 Gate at ● Gate at ●

● Curb Box

L.V.