

LABOR AND MATERIALS

1	Copper	} Connection <u>3/4</u>	\$
1	Lead		\$
1	Curb	} Cock Valve } <u>3/4</u> in.	\$
			T.S. & V.
1	Service box	} Short 3 1/2 x 4 1/2 } Long 4 1/2 x 5 1/2 } Buff or Rdway }	\$
	Old returned		\$
13	Ft. <u>3/4</u> in.		} Copper } G.I. } C.I. }
		Pipe at	
	Nipples	in. at	\$
	Bushings	to in. at	\$
	Red'g	} Coupl'gs to in. at	\$
	Inc'g		\$
	Union	in. at	\$
	Meter	in. at	\$
	Lead Joints	at	\$
	Compound Joints	at	\$
	Maintenance Foreman		\$
	Hrs. Water Maint. Man	1 at	\$
	Hrs. Water Maint. Man	2 at	\$
	Hrs. Garage Foreman	at	\$
	Hrs. Labor	at	\$
	Hrs. Compressor	at	\$
	Compensation Ins. at \$	per C	\$
	Trucking		\$
	Pav't Patch		\$
			\$
			\$
			\$
	O'head		\$
			\$

BAY


St. PL
Ave. No. 119

Name of Owner

TAX ID # 302.16-17-29

Labor and Mat'l. Report

19

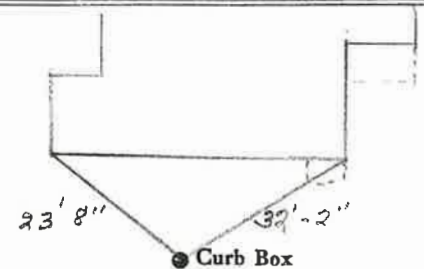

6 Main

Elev. of Main at tap 5 1/2

Gate at ●

● Gate at

● Curb Box