


LABOR AND MATERIALS

1	Copper Lead	Connection	3/4	\$
1	Curb	Cock Valve T.S. & V.	3/4 in.	\$
1	Service box	Short 3 1/2 x 4 1/2		
	Old returned	Long 4 1/2 x 5 1/2		
		Buff or Rdway		\$
12	Ft.	Copper Pipe at	3/4 in.	\$
	Nipples	in. at		\$
	Bushings	to in. at		\$
	Red'g Inc'g	Coupl'gs to in. at		\$
	Union	in. at		\$
	Meter	in. at		\$
	Lead Joints at			\$
	Compound Joints at			\$
	Maintenance Foreman			\$
	Hrs. Water Maint. Man-1 at			\$
	Hrs. Water Maint. Man-2 at			\$
	Hrs. Garage Foreman at			\$
	Hrs. Labor at			\$
	Hrs. Compressor at			\$
	Compensation Ins. at \$	per C		\$
	Trucking			\$
	Pav't Patch			\$
	O'head			\$

St. Pl.
BAY Ave. No. 121
 Name of Owner
 TAX ID # 302.16-17-28

Labor and Mat'l. Report 19

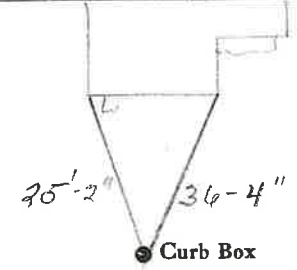

Main Elev. of
Main at tap
 Gate at • • Gate at

121 + 121 1/2 R₂ R₂ • Curb Box
 FED FROM THIS TAP
 CURB STOP IN OFF
 POSITION WHEN ON

