

### LABOR AND MATERIALS

1	Copper Lead	} Connection	<u>3/4</u>		\$
1	Curb	} Cock Valve T.S. & V.	} <u>3/4</u> in.		\$
1	Service box Old returned	{ Short 3 1/2 x 4 1/2 Long 4 1/2 x 5 1/2 Buff or Rdway }			\$
10	Ft.	3/4 in. { Copper C.I. C.I. }	Pipe at		\$
	Nipples	in. at			\$
	Bushings	to in. at			\$
	Red'g Inc'g	Coupl'gs. to in. at			\$
	Union	in. at			\$
	Meter	in. at			\$
	Lead Joints	at			\$
	Compound Joints	at			\$
	Maintenance Foreman				\$
	Hrs. Water Maint. Man-1	at			\$
	Hrs. Water Maint. Man-2	at			\$
	Hrs. Garage Foreman	at			\$
	Hrs. Labor	at			\$
	Hrs. Compressor	at			\$
	Compensation Ins.	at \$ per C			\$
	Trucking				\$
	Pav't Patch				\$
					\$
					\$
	O'head				\$
					\$


St.  
~~Pt.~~  
Ave. No. 49

BAY

Name of Owner

Labor and Mat'l. Report

19 81

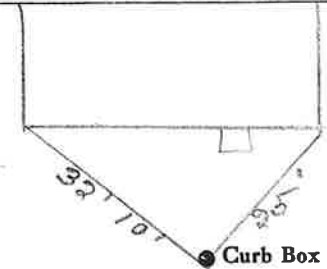

● Curb Box

10 Main

Elev. of  
Main at tap 4 1/2

Gate at ●

● Gate at

● Curb Box