


LABOR AND MATERIALS

1	Copper	} Connection $\frac{3}{4}$	\$
	Lead		
1	Curb	} $\frac{3}{4}$ in.	\$
	Cock		
	Valve		
	T.S. & V.		
1	Service box	} Short $3\frac{1}{2} \times 4\frac{1}{2}$ Long $4\frac{1}{2} \times 5\frac{1}{2}$	\$
	Old returned		Buff. or Rdway
15	Ft.	} $\frac{3}{4}$ in.	\$
			Copper
		C.I.	
		C.I.	
		Pipe at	\$
	Nipples	in. at	\$
	Bushings	to in. at	\$
	Red'g	} Coupl'gs. to in. at	\$
	Inc'g		
	Union	in. at	\$
	Meter	in. at	\$
	Lead Joints	at	\$
	Compound Joints	at	\$
	Maintenance Foreman		\$
	Hrs. Water Maint. Man-1	at	\$
	Hrs. Water Maint. Man-2	at	\$
	Hrs. Garage Foreman	at	\$
	Hrs. Labor-	at	\$
	Hrs. Compressor	at	\$
	Compensation Ins. at \$	per C.	\$
	Trucking		\$
	Pav't Patch		\$
			\$
			\$
			\$
	O'head		\$
			\$

BAY \_\_\_\_\_ St.  
Pl.  
Ave. No. 127

Name of Owner \_\_\_\_\_  
TAX ID # 302.16-17-25

Labor and Mat'l. Report 19

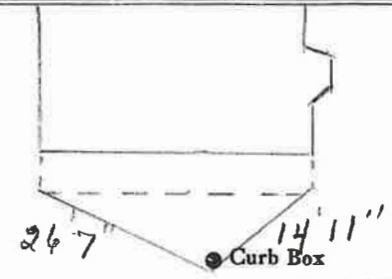

6 Main Elev. of  
Main at tap. 5 1/2

Gate at • • Gate at

• Curb Box